

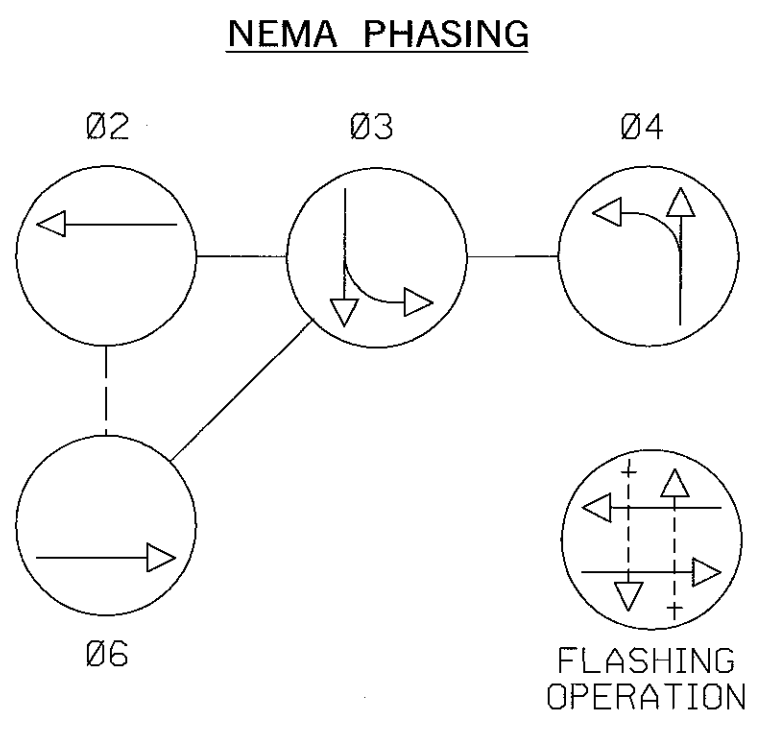
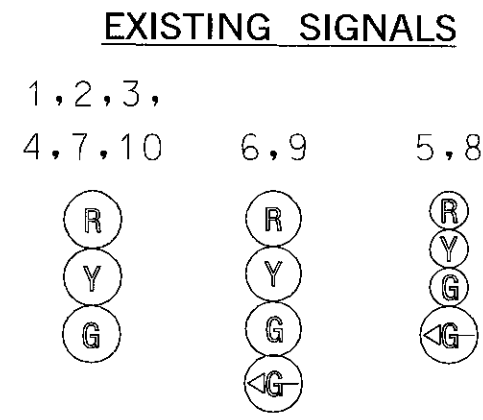


MD 273 IS ASSUMED TO RUN IN
A EAST/WEST DIRECTION

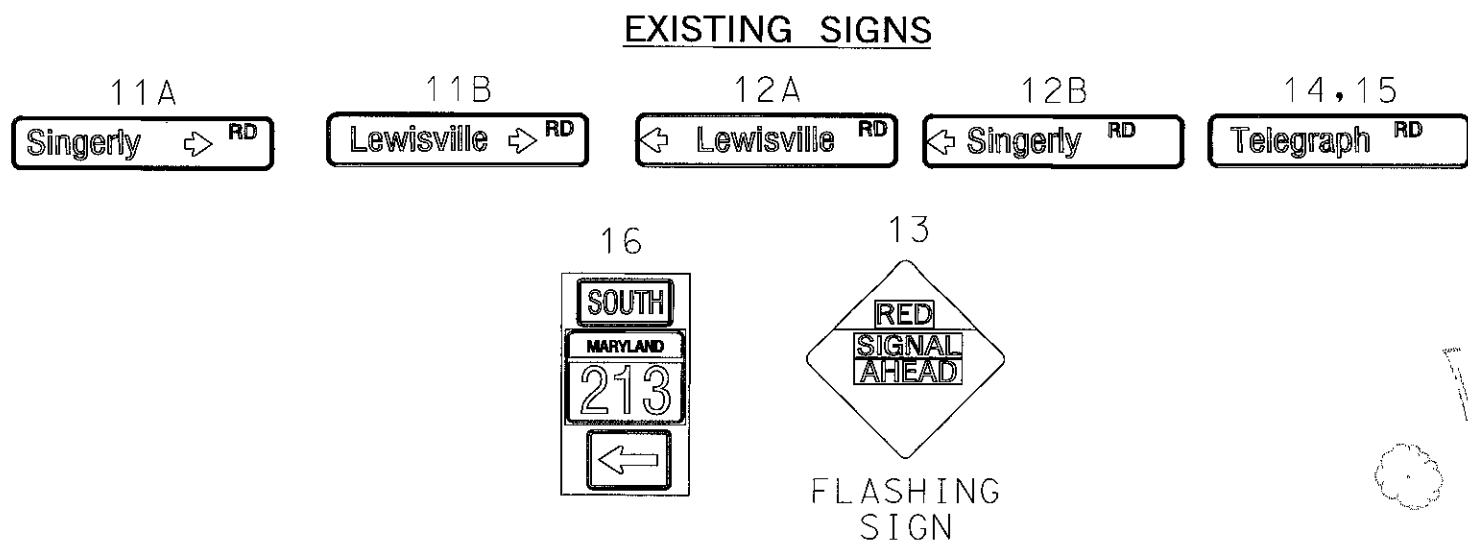

NOTE:
PHASES ASSOCIATED BY A DASHED LINE WILL OPERATE CONCURRENTLY.
PHASES ASSOCIATED BY A SOLID LINE WILL NOT OPERATE CONCURRENTLY.

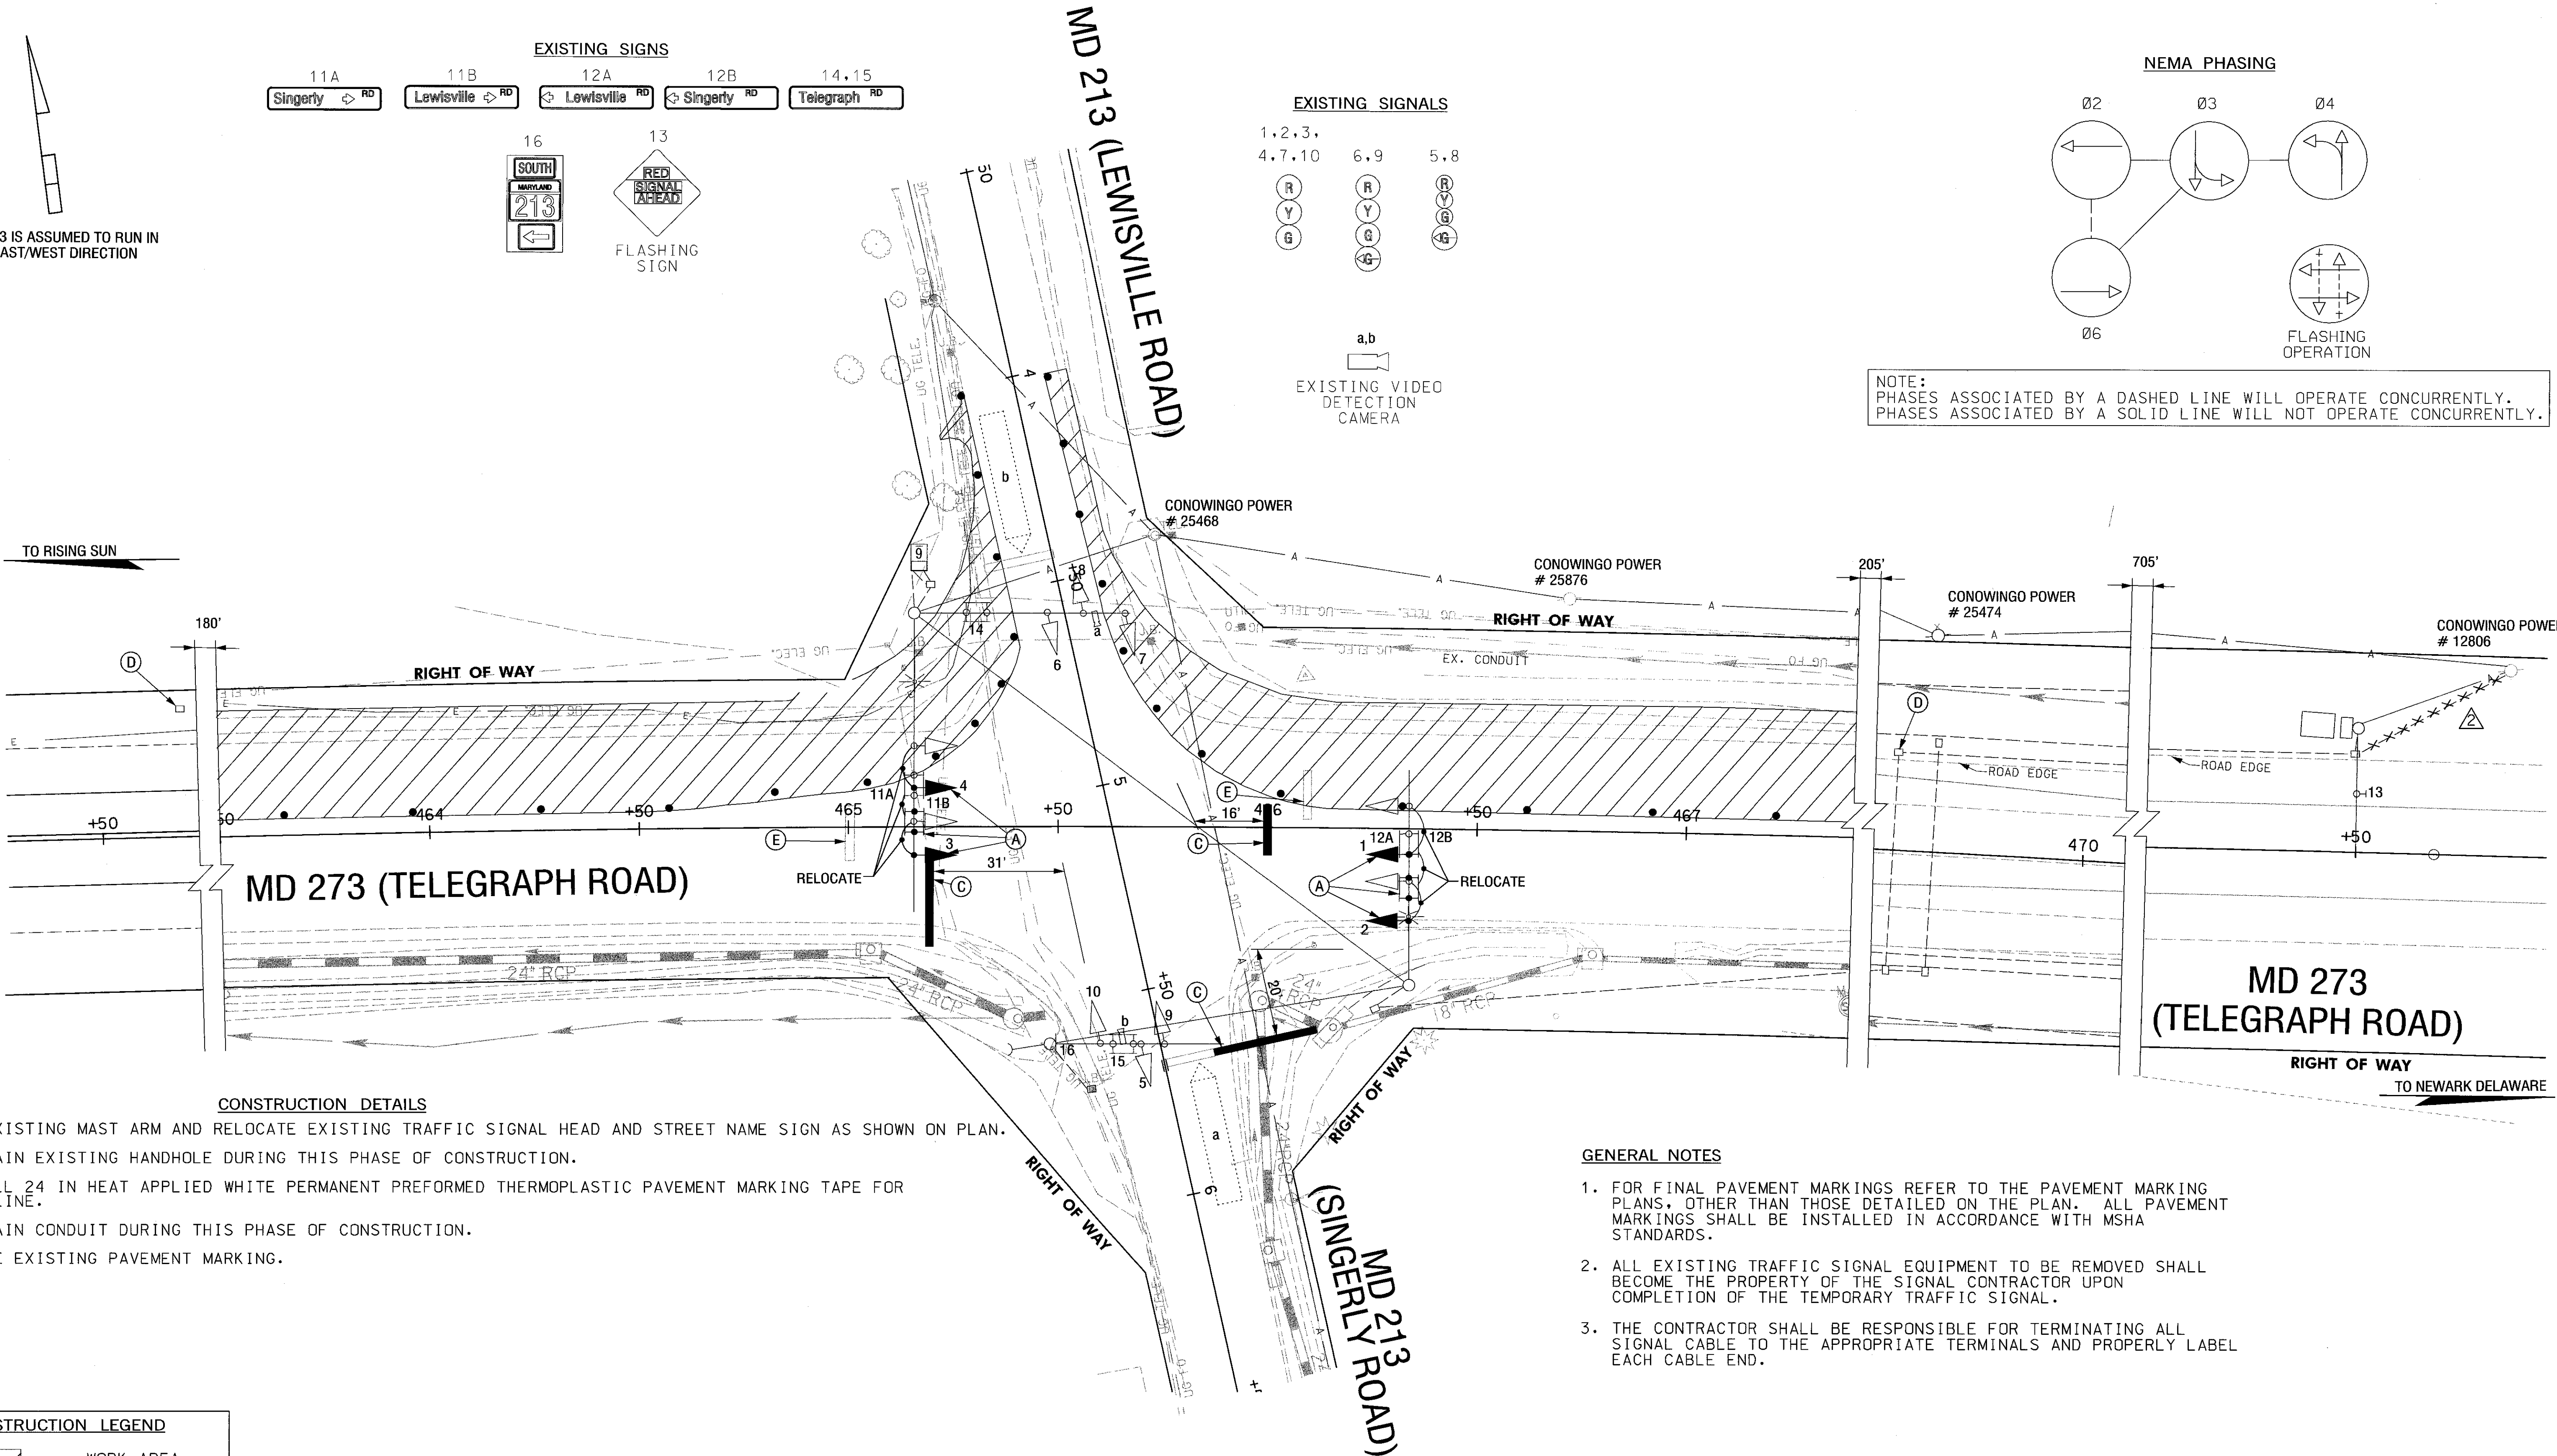

- CONSTRUCTION DETAILS
- A. USE EXISTING MAST ARM AND RELOCATE EXISTING TRAFFIC SIGNAL HEAD AND STREET NAME SIGN AS SHOWN ON PLAN.
 - B. MAINTAIN EXISTING HANDHOLE DURING THIS PHASE OF CONSTRUCTION.
 - C. INSTALL 24 IN HEAT APPLIED WHITE PERMANENT PREFORMED THERMOPLASTIC PAVEMENT MARKING TAPE FOR STOP LINE.
 - D. MAINTAIN CONDUIT DURING THIS PHASE OF CONSTRUCTION.
 - E. REMOVE EXISTING PAVEMENT MARKING.

- GENERAL NOTES
- 1. FOR FINAL PAVEMENT MARKINGS REFER TO THE PAVEMENT MARKING PLANS, OTHER THAN THOSE DETAILED ON THE PLAN. ALL PAVEMENT MARKINGS SHALL BE INSTALLED IN ACCORDANCE WITH MSHA STANDARDS.
 - 2. ALL EXISTING TRAFFIC SIGNAL EQUIPMENT TO BE REMOVED SHALL BECOME THE PROPERTY OF THE SIGNAL CONTRACTOR UPON COMPLETION OF THE TEMPORARY TRAFFIC SIGNAL.
 - 3. THE CONTRACTOR SHALL BE RESPONSIBLE FOR TERMINATING ALL SIGNAL CABLE TO THE APPROPRIATE TERMINALS AND PROPERLY LABEL EACH CABLE END.

CONSTRUCTION LEGEND

WORK AREA

GEOMETRIC LEGEND

EXISTING
PROPOSED

UTILITY LEGEND

SD STORM DRAIN
G GAS MAIN
W WATER MAIN
S SEWER MAIN
E ELECTRIC CABLES
A AERIAL CABLES
T TELEPHONE CABLES
F FIBER-OPTIC

SABRA, WANG & ASSOCIATES, INC.

1804 JOH AVENUE
SUITE 160
BALTIMORE, MD 21227
(410) 737-6564
WWW.SABRA-WANG.COM

REVISIONS	APPROVALS
SHA NO. CE4415176 12/20/04 ADDENDUM No. 2 SWA 10/16/04 SHA NO. CE4415176 08/20/04 MODIFICATION DUE TO GEOMETRIC CHANGES SWA 10/16/04 SHA NO. 012000 07/20/01 AS BUILT CHANGE TO MD 213 TO A SIDE STREET SPLIT C SHA NO. 8582504002 UPGRADE I.C.B. TO SIGNAL PRD DJD DAZ EJP TJH	TEAM LEADER, TRAFFIC ENGINEERING DESIGN DIVISION ASST. CHIEF, TRAFFIC ENGINEERING DESIGN DIVISION CHIEF, TRAFFIC ENGINEERING DESIGN DIVISION DIRECTOR, OFFICE OF TRAFFIC & SAFETY

ADDENDUM No. 2

M.O.T. PHASE 2

SHA MARYLAND DOT - STATE HIGHWAY ADMINISTRATION
Office of Traffic & Safety
TRAFFIC ENGINEERING DESIGN DIVISION
TRAFFIC SIGNAL PLAN
MD 273 (TELEGRAPH ROAD) AT
MD 213 (LEWISVILLE /SINGERLY ROAD)

DRAWN BY: M. LINARDI
CHECKED BY: W.F. FITCH
SCALE: 1" = 20'
DATE: 01/15/1973

F.A.P. NO.
S.H.A. NO. 23854T2502873
COUNTY: CECIL
LOG MILE: 07021326.20

TS NO.
TS-838 E
T.I.M.S. NO.
F246

SHEET NO.
25 OF 28